

Vicinity Plan  
(Not to Scale)

C:\PROJECTS\00 Vicini-



Notes:

1. Boundary description and North arrow refer to P.W.D. drawing No. 1272.
2. This property appears to lie within "Zone X", according to the Flood Insurance Rate Map Community Panel No. 780000 0074 G.
3. Property is currently zoned R-2.
4. This plan does not constitute a boundary survey. The boundary information shown hereon has been transcribed from Public Works Drawings. Lot corners indicated as "found" have not been verified in relation to the perimeter.


To:

Kenneth & Patricia Maliga  
First Liberty Mortgage

- |  |  |
|--|--|
| <input checked="" type="checkbox"/> Chicago Title Insurance Co.,           | <input type="checkbox"/> Trinity Title & Trust Co.,                    |
| <input checked="" type="checkbox"/> Lawyer's Title Insurance Co.,          | <input checked="" type="checkbox"/> Island Title Services Corporation, |
| <input checked="" type="checkbox"/> Stewart Title Guaranty                 | <input type="checkbox"/> Virgin Islands Title & Trust Co.,             |
| <input type="checkbox"/> Fidelity National Title Insurance Co. of New York |  |

Legend:

- |                        |                           |  |
|------------------------|---------------------------|--|
| Plot No. 49 Prop. Line | Utility Pole              |  |
| Other Property Line    | Unmarked Corner           |  |
| Setback Line           | Concrete Monument (Found) |  |

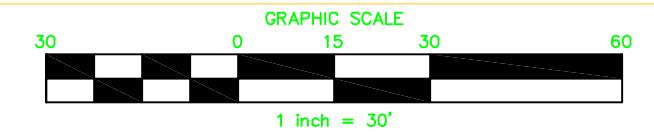

As Built Survey  
Plot No. 49  
Estate Solitude  
Eastend "B" Quarter  
St. Croix U.S. Virgin Islands

Prepared By:  
GME Dospiva, LLC  
P.O. Box 25105 Gallows Bay  
St. Croix VI 00824  
PHONE (340)778-7474  
FAX (340)778-7476  
Drawn By: PJC

DATE: May 11, 2009

FILE NO.  
09082

